
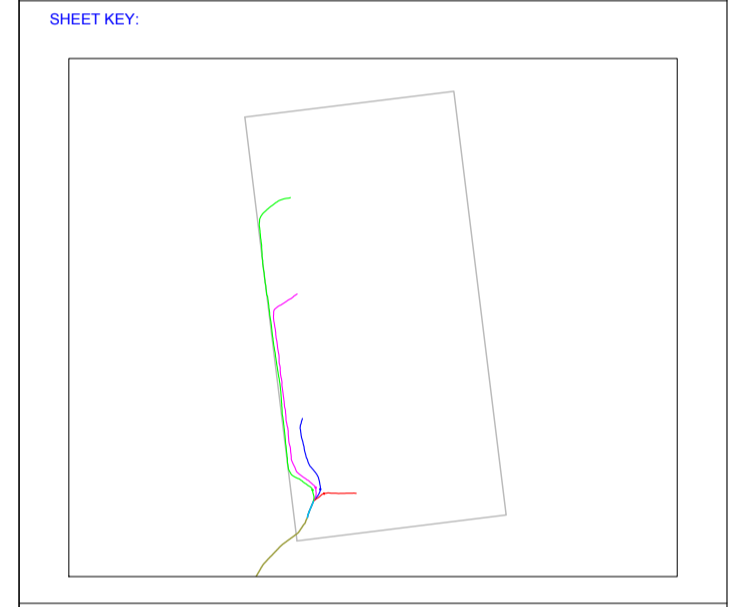


GENERAL NOTES:

- As-built bathymetric data acquired on 12th August 2016 onboard M/V MTS Xplorer. Other seabed data provided by the client.
- Bathymetric contours reduced to LAT using UKHO VDatum model.
- Positions are referenced to the WGS84 compatible datum, European Terrestrial Reference System (ETRS 89).

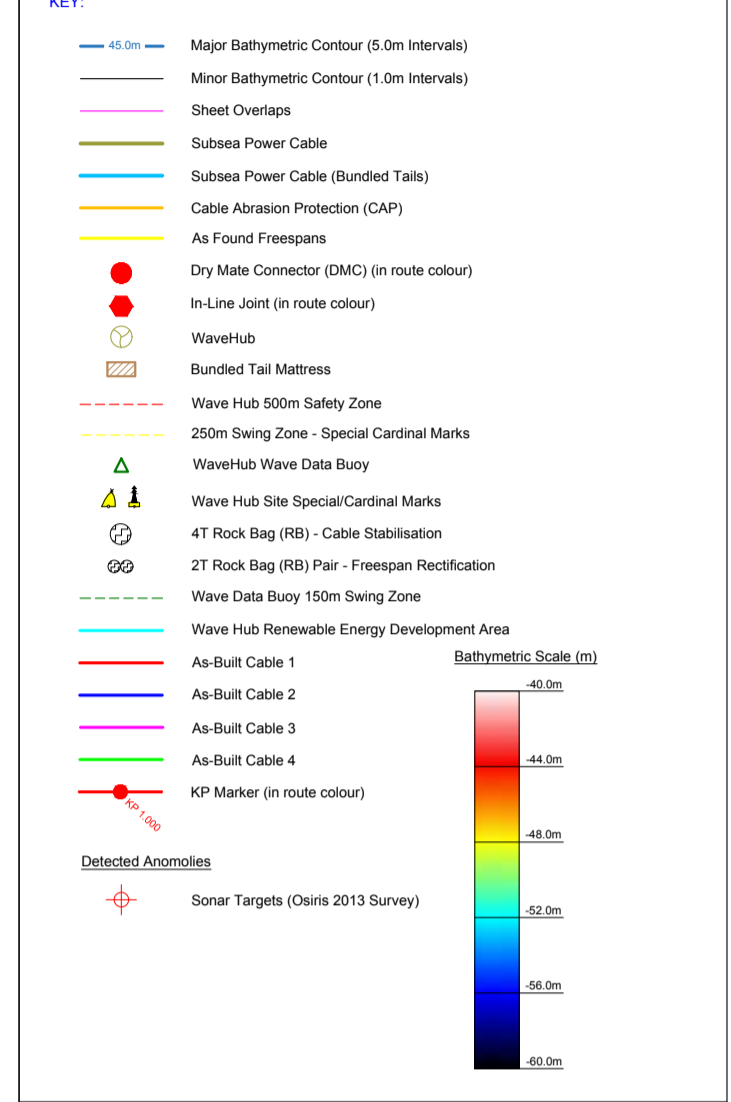

GEODETTIC NOTES:

Projection: Universal Transverse Mercator (Zone 30 North)
 Datum: WGS84
 Latitude of Origin: 00°00'00"N
 Longitude of Origin: 000°00'00"W
 False Easting: 500 000.00m
 False Northing: 00.00m
 Scale Factor: 0.999 603 300
 Ellipsoid: WGS84

SITE DEVELOPER:

Wave Hub Ltd
 City Cable
 Hayle Marine Renewable Business Park
 North Quay, Hayle, Cornwall
 TR27 4DD
 United Kingdom
 Tel: +44 (0)1736 800 290
 Web: www.wavehub.co.uk

OFFSHORE WORKS CONTRACTOR:

James Fisher and Sons plc
 Marine Services Worldwide
 James Fisher Marine Services Ltd
 Fisher House
 Michaelson Road
 Barrow-in-Furness, Cumbria
 LA14 1HR
 United Kingdom
 Tel: +44 (0)1229 615 400
 Web: www.james-fisher.com

SURVEY CONTRACTOR:

Insight Marine Projects Ltd
 15A Normandy Way
 Bodmin
 Cornwall
 PL31 1RB
 United Kingdom
 Tel: +44 (0)1208 77033
 Web: www.insightmarine.com

REV	DATE	REVISION / DESCRIPTION	DRAWN	CHKD	APP
A5	08/08/16	OMM AMENDMENTS	ALR	DC	GB
A4	07/08/16	OMM AMENDMENTS	ALR	DC	GB
A3	25/08/16	OMM AMENDMENTS	ALR	DC	GB
A2	23/08/16	ISSUED FOR CLIENT REVIEW	ALR	DC	GB
A1	23/08/16	ISSUED FOR INTERNAL REVIEW	ALR	RF	GB

CONTRACT TITLE:
WaveHub Cable Tail Installation

CHART TITLE:
As-Built - KP Chart

HORIZONTAL SCALE:

SCALE: 1:9000 **SHEET:** 1 of 5 **ORIGINAL PLOT SIZE:** A1

DRAWN: ALR **CHKD:** RF **APP:** GB

FILE REFERENCE: DWG-0289-J64604 **REV:** A5